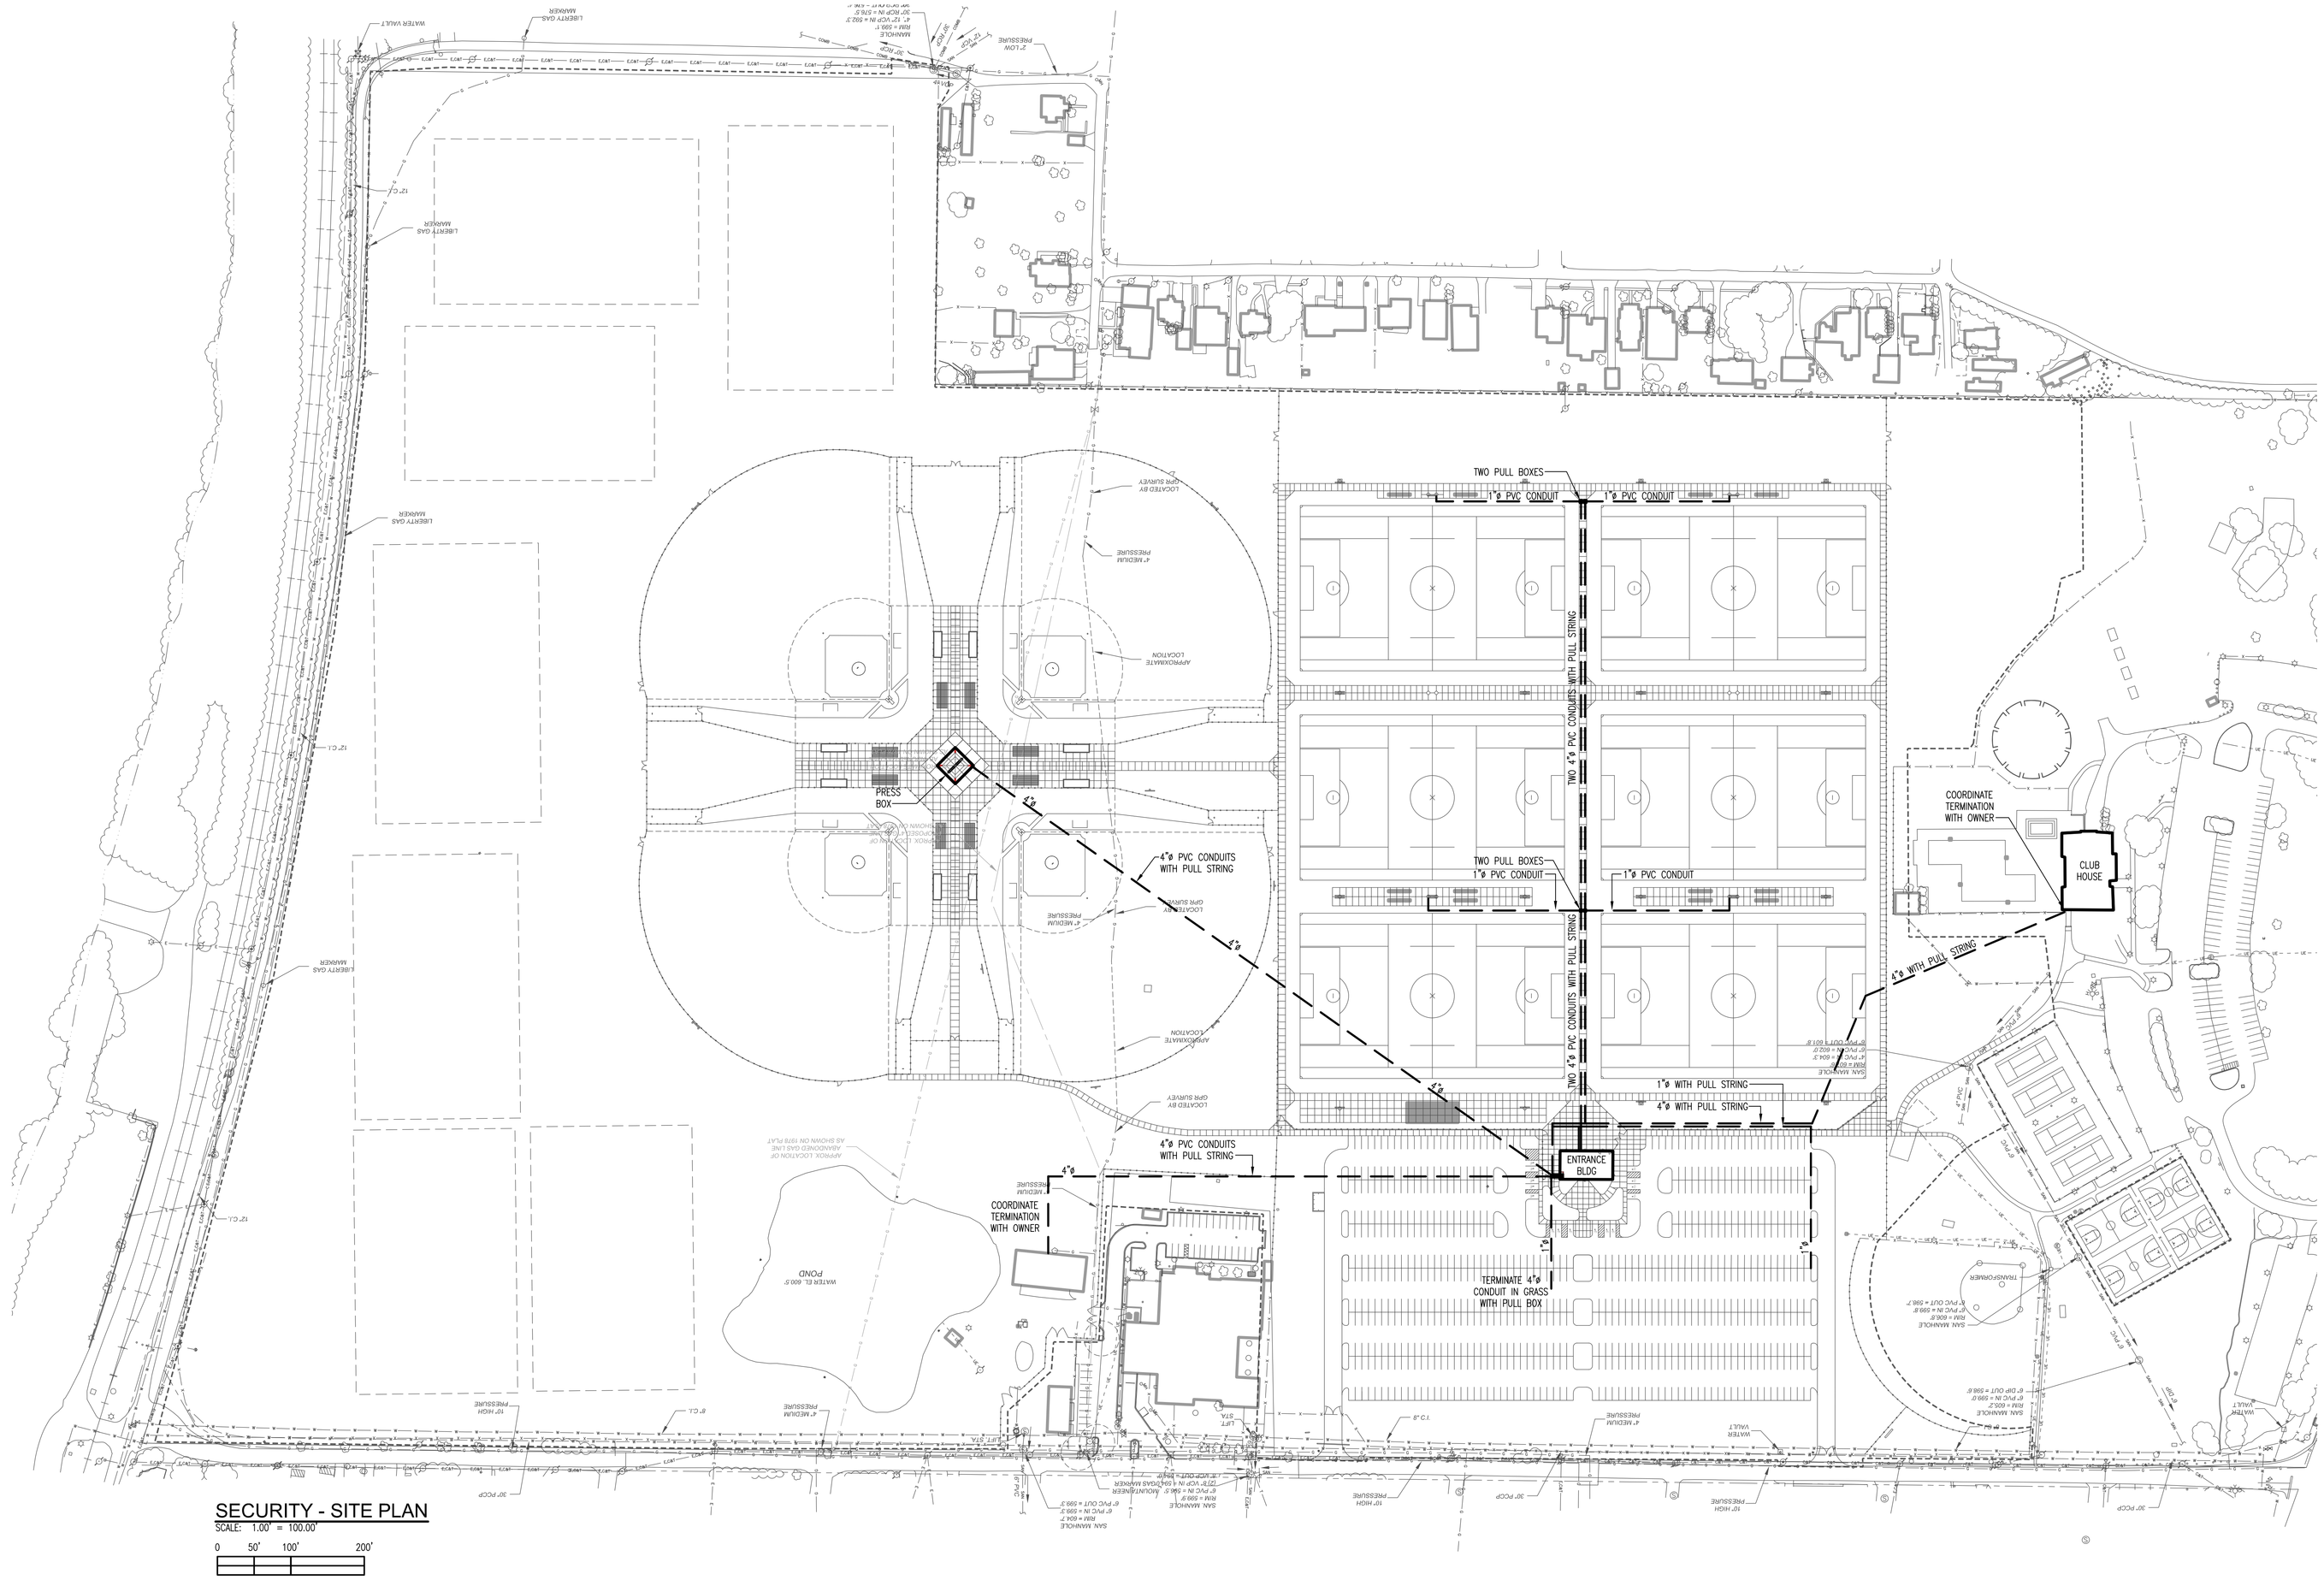

SECURITY - SITE PLAN

SCALE: 1.00" = 100.00'

0 50' 100' 200'

ZMM
ARCHITECTS & ENGINEERS

222 Lee Street, West
Charleston, West Virginia 25302
Phone: 304.342.0159
Fax: 304.345.8144

www.zmm.com

NO.	DESCRIPTION	DATE

REVISIONS

SHAWNEE PARK
MULTI-SPORT COMPLEX
KANAWHA COUNTY COMMISSION
INSTITUTE, WV

© by ZMM, INC.

ELECTRICAL SECURITY PLAN (AS BUILT)

DRAWN	CHECKED
MWE	MWE
	DATE: 5 / 18 / 2018
	COMM. NO.: 17084

E123XR

May 18, 2018 M:\Shawnee Park Sports Complex (17084)_Mechanical\z17084Sitedwg.dwg